

KEY

PROPOSED VEGETATION CLEARANCE (AREA = 344 M²)
 EXISTING TO BE LOWERED AND, IF REQUIRED, UPGRADE TO 400 OR SIMILAR APPROVED
 EXISTING TO REMAIN (EXL, NO)
 EXISTING SIGN TO BE REMOVED. REFER TO NOTE 4.
 EXISTING SIGN TO REMAIN.
 PROPOSED SIGN. REFER TO NOTE 8.
 EXISTING GULLIES TO REMAIN
 EXISTING VERGE TO REMAIN
 PROPOSED ISLAND LAYOUT
 PROPOSED ACC DRAIN (LENGTH = 7m)
 HIGH VOLTAGE OVERHEAD ELECTRICITY CABLE (11KV).
 PROPOSED DRAINAGE PIPE
 EXISTING DRAINAGE PIPE

NOTES


- REFER TO HE601561-KIER-GEN-A34_E_ILSLEY_NB-DR-D-0100_D3 FOR SCHEME EXTENTS.
- REFER TO 0112 SERIES FOR SETTING OUT DETAILS.
- REFER TO 0116 SERIES FOR DETAILED SIGN LOCATION AND UTILITY PLAN.
- REFER TO 0200 SERIES FOR SITE CLEARANCE DETAILS
- REFER TO 0500 SERIES FOR DRAINAGE DETAILS
- REFER TO 0700 SERIES FOR PAVEMENT AND CROSS SECTION DETAILS.
- REFER TO 1100 SERIES FOR KERB DETAILS.
- REFER TO 1200 SERIES FOR SIGN AND ROAD MARKING DETAILS.
- REFER TO 3000 SERIES FOR LANDSCAPING DETAILS.

RESIDUAL DESIGN HAZARDS

THE FOLLOWING HAS BEEN CONSIDERED AS PART OF THE PROPOSED DESIGN INFORMATION AND IS NOT TO BE TAKEN AS A RESIDUAL HAZARD

H34 - HEALTH AND SAFETY RISK REFERENCE NUMBER
 H35 - ENVIRONMENT RISK REFERENCE NUMBER
 E4 - ENVIRONMENT RISK REFERENCE NUMBER

H34 - OVERHEAD ELECTRICITY CABLES (11KV)
 H35 - EXISTING DRAINAGE PIPE

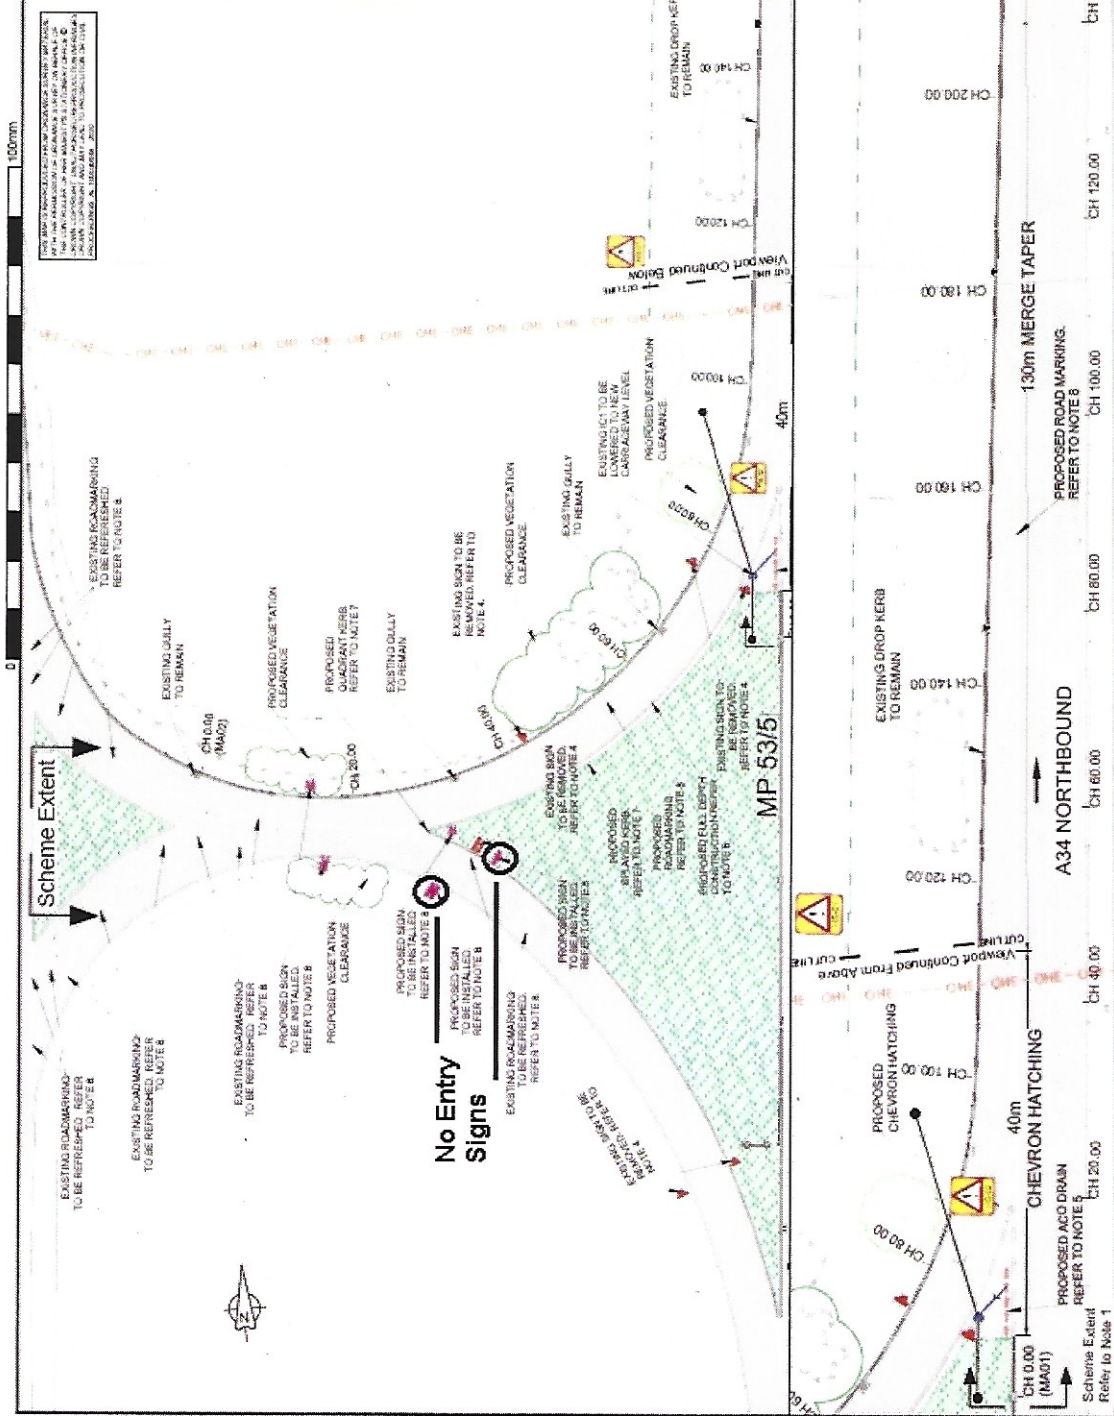

REV	DESCRIPTION	CHK'D	APP'D	DATE
C3	ADDITION OF NO-ENTRY SIGN	SH	OB	04-05-20
C2	FOR PRICING	SH	OB	30-03-20
C1	FOR INFORMATION	OB	TP	04-03-20

DRAWING NUMBER	PROJECT	ORIGINATOR	VOLUME	SCHEME REFERENCE No.
HE601561	A34_E_ILSLEY_NB	KIER	GEN	1240109
		DR	D	REVISION
		TYPE	ROLE	NUMBER
				C3

DRAWN:	BT	SCALE	NOT TO SCALE	DRAWING STATUS
DESIGN:	JB	DIMENSIONS:	m	WORK IN PROGRESS
CHK'D:	SH	ORIG DWG SIZE:	A3	PRELIMINARY DRAWING
APP'D:	OB	COPYRIGHT © KIER		EXTERNAL ISSUE
DATE:	12/02/2020			AS-BUILT
SUITABILITY:	D1			

FOR COSTING / PRICING / FINANCIAL

CLIENT: **highways england**

AGENT: **KIER**

SCHEME NAME: A34 NB EAST ILSLEY JUNCTION IMPROVEMENTS

DRAWING TITLE: GENERAL ARRANGEMENT SHEET 1 OF 1

MP 53/7
 CH 240.00
 CH 220.00
 CH 200.00
 CH 180.00
 CH 160.00
 CH 140.00
 CH 120.00
 CH 100.00
 CH 80.00
 CH 60.00
 CH 40.00
 CH 20.00
 CH 0.00 (MA001)

130m MERGE TAPER
 A34 NORTHBOUND

Viewpoint Continued Below
 Viewpoint Continued From Above

Scheme Extent Ready to Issue 1